
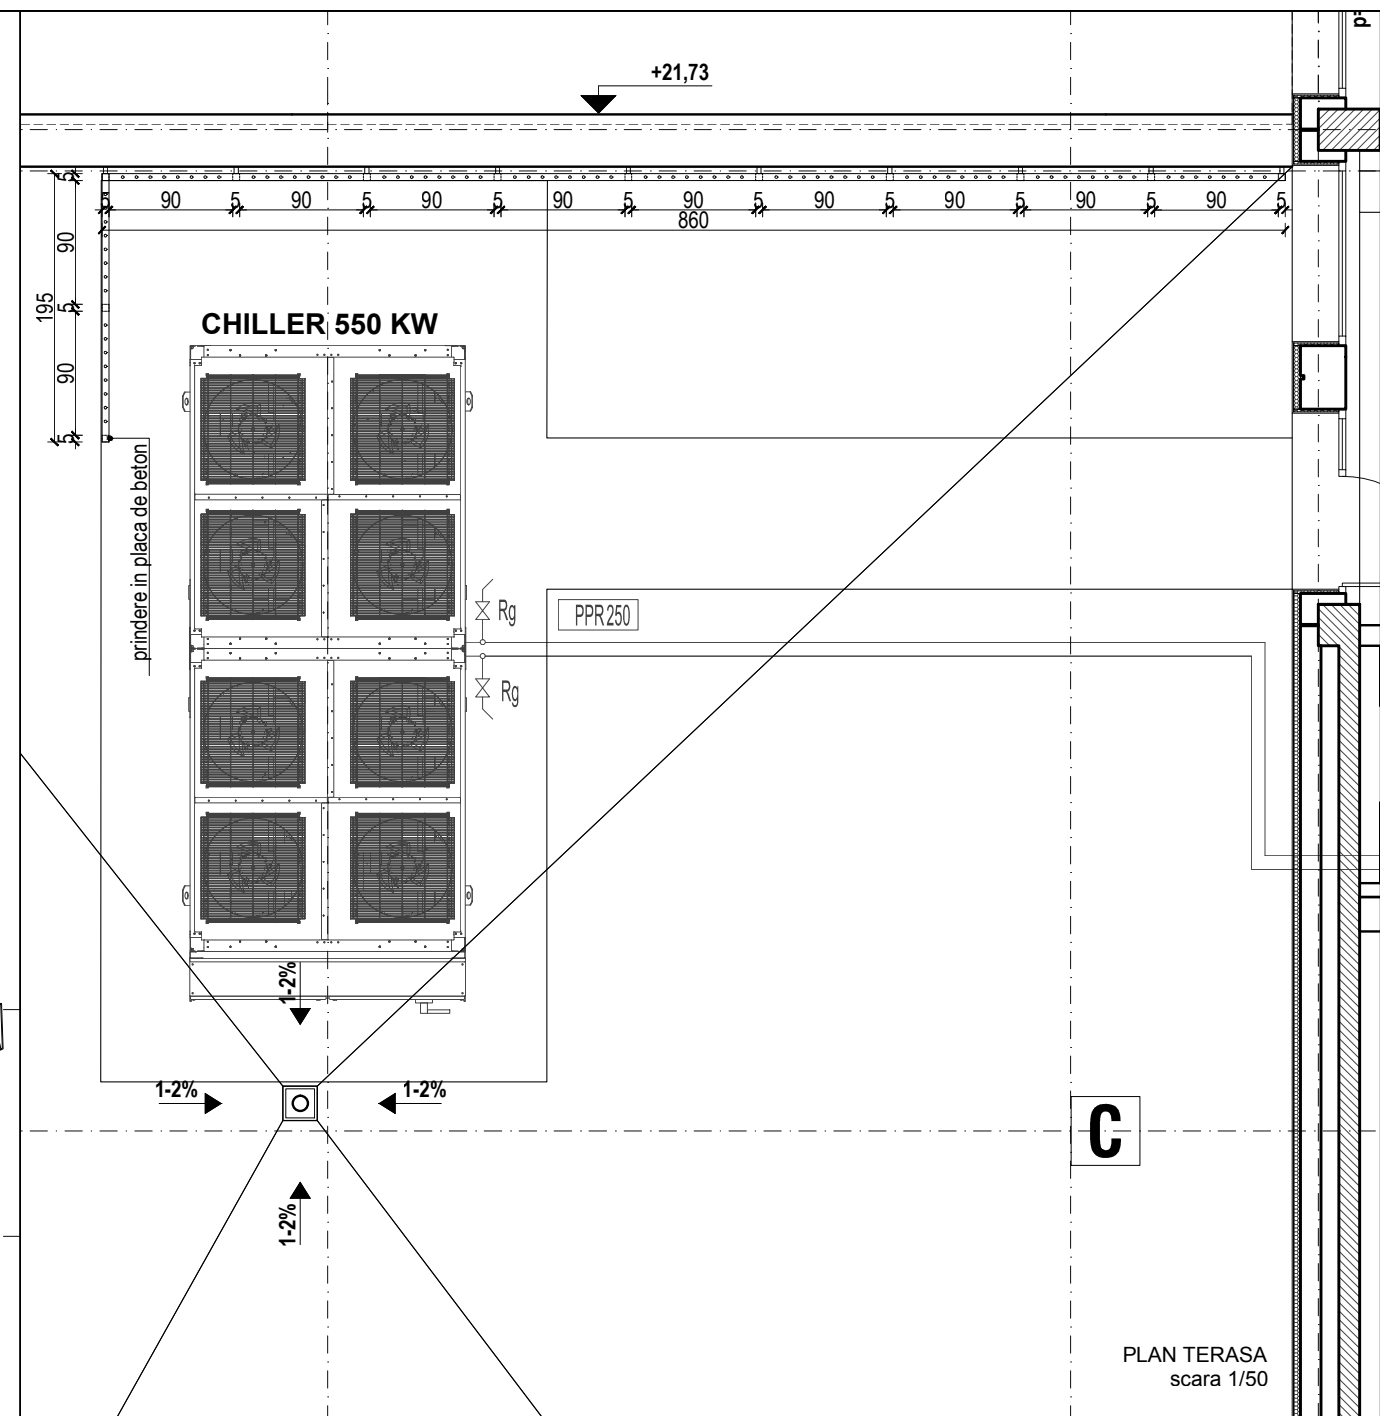


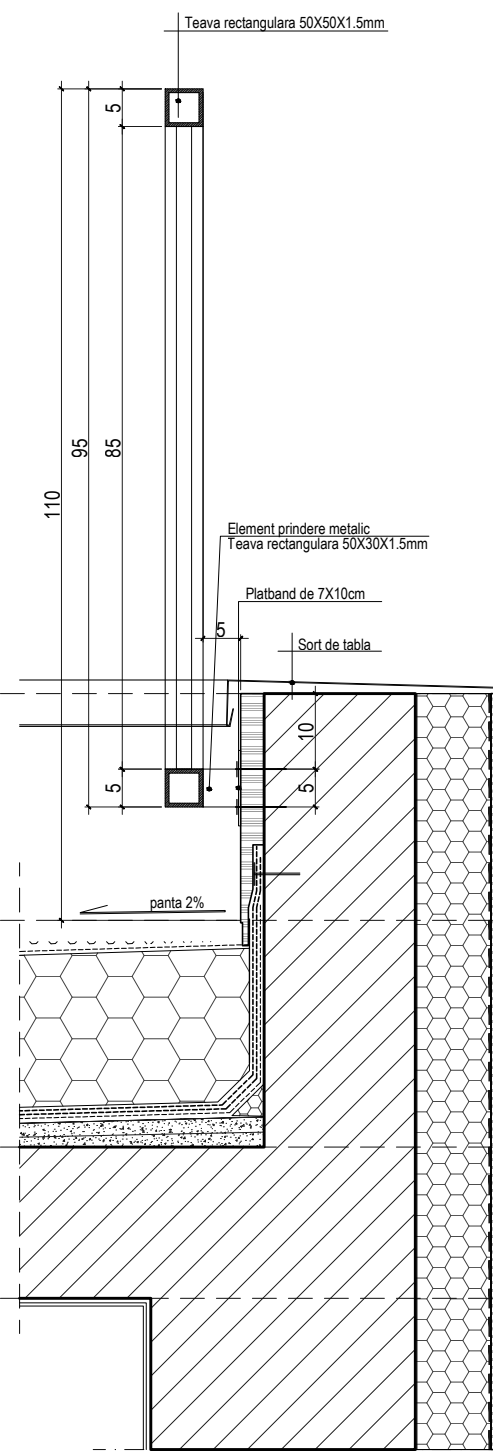

EXPERT	NUME	SEMNATURA	CERINTA	REFERAT / EXPERTIZA NR./ DATA	
VERIFICATOR/ EXPERT					
PROIECTANT GENERAL:  SC "TDD CONCEPT STUDIO" SRL CIF 23108690, J22/ 223/2008			Beneficiar: JUDETUL VASLUI		Proiect nr. 19/2010 Contract nr. 2025/2010
SPECIFICATIE	NUME	SEMNATURA	SCARA 1/10 1/50	REABILITARE, MODERNIZARE SI ECHIPARE SPITALUL JUDETEAN DE URGENTE VASLUI str. Stefan cel Mare, nr.233, Vaslui	Faza. P.Th.+D.E.
SEF PROIECT	arh. Gabriela Tanjala				
PROIECTAT	arh. Gabriela Tanjala		2016	DETALIU BALUSTRADA DE PROTECTIE ETAJ 6, CORP A si B	Plansa nr. D25-AB
DESENAT	arh. Ana-Maria Plesco				