


T1E4

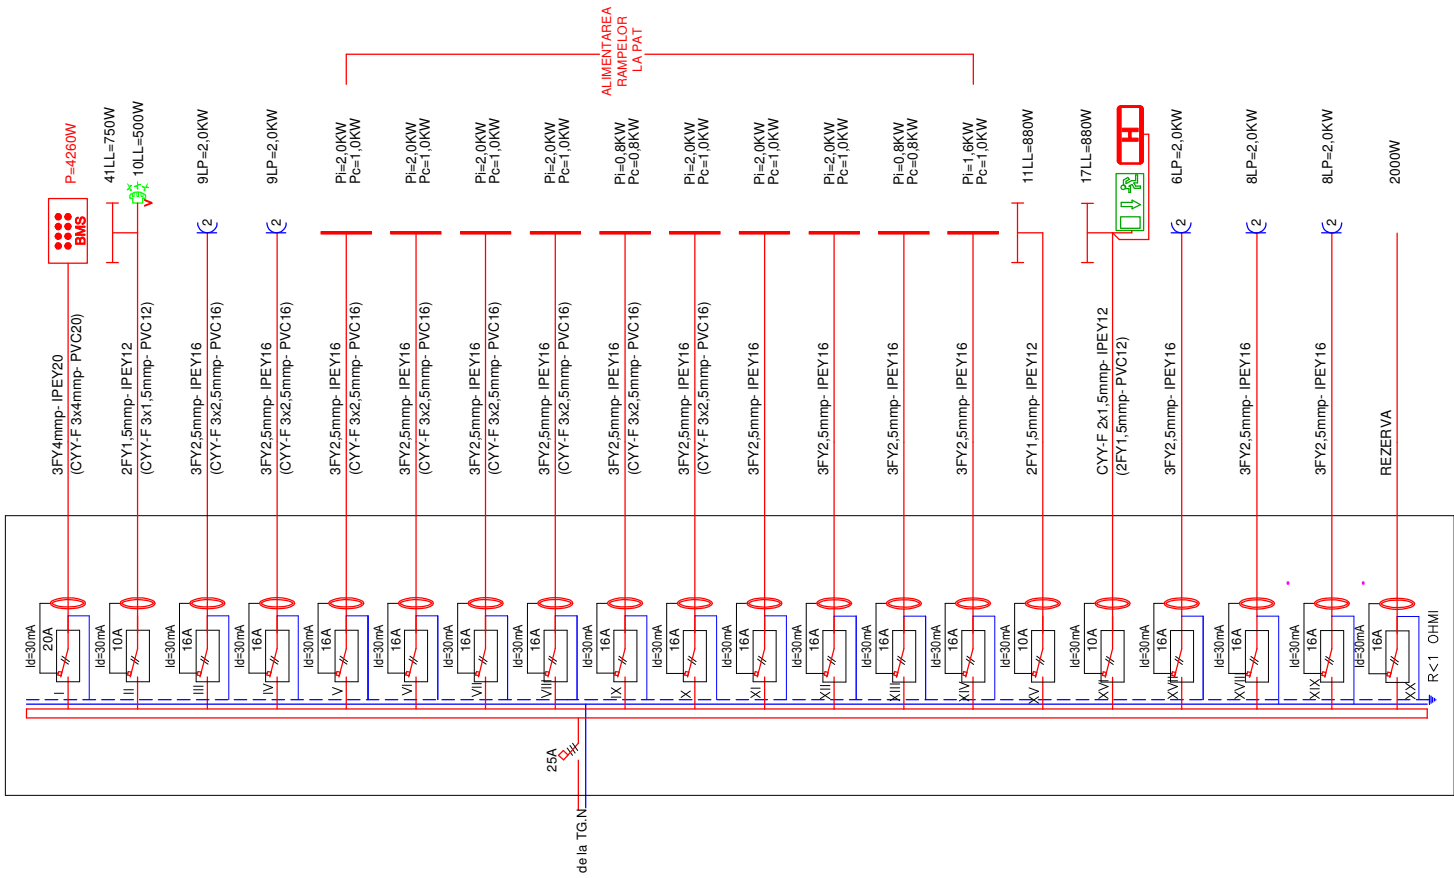


C	Receptor	Pi [W]	Faza	Destinația
C1	51LL	4260	L1	alimentare prin BMS1 iluminatul din saloane holuri si vcv.
C2	18LL	1250	L2	iluminat intrare in saloane, baile si ventilatoare le, sas, magazi, g.s. birou camera asistente
C3	9LP	2000	L3	prize saloane cardiologie 1,2,3,4 si salon medicina interna 2
C4	9LP	2000	L2	prize saloane medicina interna 1,2 si cardiologie 5,6,7
C5	1CR	2000	L1	alimentare rampe salon cardiologie 1
C6	1CR	2000	L1	alimentare rampe salon cardiologie 2
C7	1CR	2000	L3	alimentare rampe salon cardiologie 3
C8	1CR	2000	L3	alimentare rampe salon cardiologie 4
C9	1CR	800	L3	alimentare rampe salon medicina interna 3
C10	1CR	2000	L2	alimentare rampe salon medicina interna 2
C11	1CR	2000	L2	alimentare rampe salon medicina interna 1
C12	1CR	2000	L2	alimentare rampe salon cardiologie 5
C13	1CR	800	L1	alimentare rampe salon cardiologie 6
C14	1CR	1600	L3	alimentare rampe salon cardiologie 7
C15	11LL	880	L2	iluminat sala tratament camera asistente, cancelarie medici si explorari functionale
C16	17LL	880	L1	iluminat grupuri sanitare camere de garda spatii tehnice si servii
C17	6LP	2000	L1	prize sala tratament camera asistente, cancelarie medici
C18	8LP	2000	L3	prize explorari functionale si camera asistente
C19	6LP	2000	L3	prize salon medicina interna 3 camere de garda spatii tehnice si servii
C20	rezerva	2000	L2	rezerva

P _{L1} [W]	P _{L2} [W]	P _{L3} [W]	P ₁ [W]	C _s	P _a [W]
11940	12130	12400	36470	0,35	12800

I_c= 24.3 [A]

T1E4V

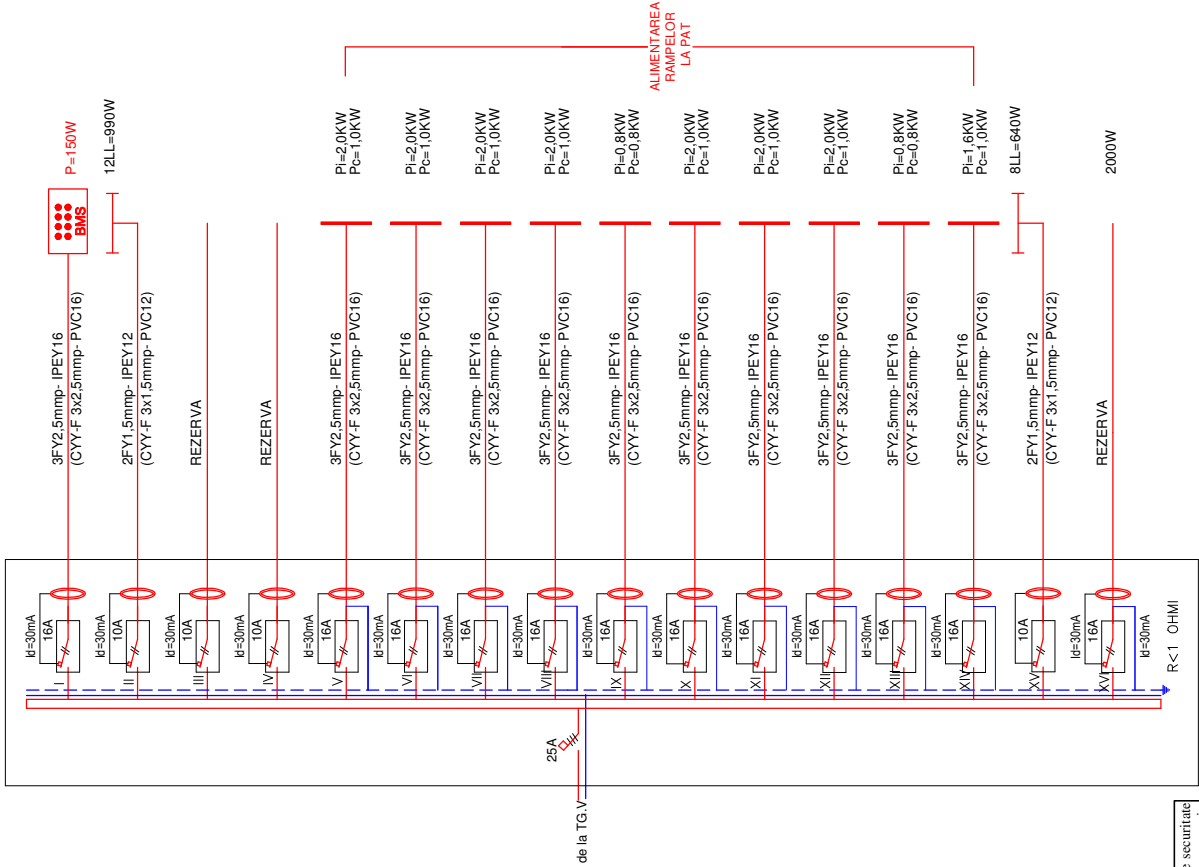

NOTA:
Prezentata plansa contine modificarile realizate pe parcursul executiei, prin dispozitii de santier, inclusiv masurile stabilite prin expertiza tehnica la foc, elaborata de ing. Simon Vasile (dupa caz).
Plansa are notatia din proiectul tehnic, la care s-a adaugat abrevierea "AsB"

C	Receptor	Pi [W]	Faza	Destinația
C1	18 LL	150	L2	alimentare prin BMS1 iluminatul de veghe
C2	12 LL	990	L3	iluminat de supraveghere si iluminat sala tratamente
C3	rezerva	220	L3	rezerva
C4	rezerva	40	L2	rezerva
C5	1CR	2000	L1	alimentare rampe salon cardiologie 1
C6	1CR	2000	L1	alimentare rampe salon cardiologie 2
C7	1CR	2000	L1	alimentare rampe salon cardiologie 3
C8	1CR	2000	L2	alimentare rampe salon cardiologie 4
C9	1CR	800	L1	alimentare rampe salon medicina interna 3
C10	1CR	2000	L2	alimentare rampe salon medicina interna 2
C11	1CR	2000	L3	alimentare rampe salon medicina interna 1
C12	1CR	2000	L3	alimentare rampe salon cardiologie 5
C13	1CR	800	L3	alimentare rampe salon cardiologie 6
C14	1CR	1600	L2	alimentare rampe salon cardiologie 7
C15	8LL	640	L3	iluminat hol principal
C16	rezerva	2000	L2	rezerva

P _{L1} [W]	P _{L2} [W]	P _{L3} [W]	P ₁ [W]	C _s	P _a [W]
6800	7790	6650	21240	0,35	7450

I_c= 14.1 [A]

VERIFICATOR VERIFICATOR/ EXPERT	NUME	SEMNATURA	CERINTA	REFERAT NR.	din
PROIECTANT GENERAL: SC "TDD CONCEPT STUDIO" SRL CIF 23108690, J22/ 223/2008			PROIECTANT SPECIALITATE: SC "ROLPROIECT" SRL CIF 18050370, J22/ 2578/2005	REFERAT / EXPERTIZA NR./ DATA	
SPECIFICATIE			NUME	Beneficiar	
SEF PROIECT	ing. C.Tanjala Ostapovici	SEMNATURA	SCARA %	CONSILIUL JUDETEAN VASLUI	
PROIECTAT	ing. Florin BARAN			REABILITARE, MODERNIZARE SI ECHIPARE SPITALUL JUDETEAN DE URGENTE VASLUI	
DESENAT	ing. Andreea BARAN			Faza. PTh	
VERIFICAT			2016	Scheme de distributie tablouri electrice T1E4 si T1E4V - instalatii electrice curenti tari -	
				str. Stefan Cel Mare, nr. 233,Vaslui	
				Plansa nr. ET-21/AsB	