



TCV.V

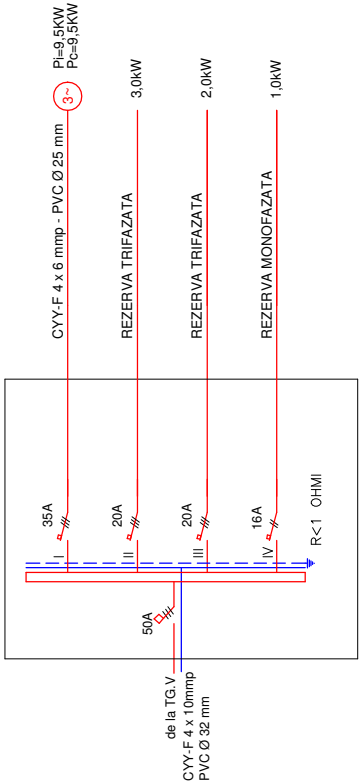

C	Receptor	Pi [W]	Faza	Destinația
C1	CTA 3	9500	L1,L2,L3	centrala de tratare aer 3
C2	rezerva	3000	L1,L2,L3	rezerva
C3	rezerva	2000	L1,L2,L3	rezerva
C4	rezerva monofazata	1000	L1	rezerva monofazata
		Pi [W]	Cs	Pa [W]
		15500	1	9500

Ic=18.1 [A]


TLIFTURI

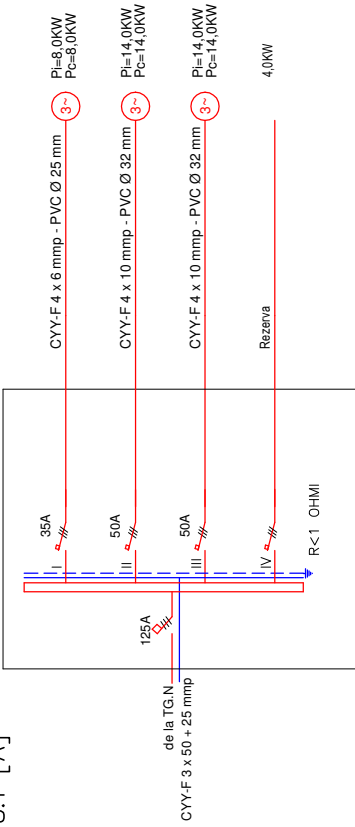

C	Receptor	Pi [W]	Faza	Destinația
C1	1LIFT	8000	L1,L2,L3	lift 8 persoane
C2	1LIFT	14000	L1,L2,L3	lift transport 21 persoane
C3	1LIFT	14000	L1,L2,L3	lift transport 21 persoane
C4		4000	L1,L2,L3	Rezerva
		Pi [W]	Cs	Pa [W]
		40000	1	36000

Ic=68,5 [A]

TC.V

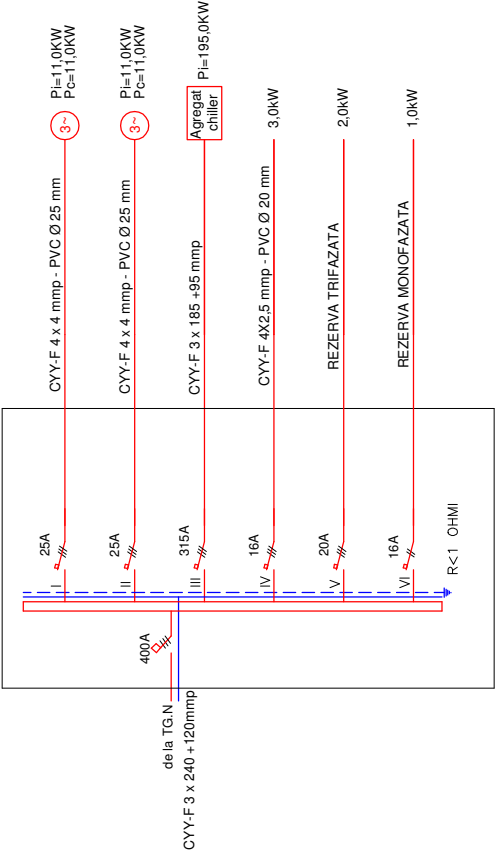

C	Receptor	Pi [W]	Faza	Destinația
C1	CTA 1	11000	L1,L2,L3	centrala de tratare aer 1
C2	CTA 2	11000	L1,L2,L3	centrala de tratare aer 2
C3	CHILLER	195000	L1,L2,L3	chiller
C4	pompa circulatie	3000	L1,L2,L3	pompa circulatie
C5	rezerva trifazata	2000	L1,L2,L3	rezerva trifazata
C6	rezerva monofazata	1000	L1	rezerva monofazata
		Pi [W]	Cs	Pa [W]
		223000	0,98	220000

Ic=418.0 [A]

NOTA:
Prezenta plansa contine modificarile realizate pe parcursul executiei, prin dispozitii de santier, inclusiv masurile stabilite prin expertiza tehnica la foc, elaborata de ing. Simon Vasile (dupa caz).
Plansa are notatia din proiectul tehnic, la care s-a adaugat abrevierea "AsB"

VERIFICATOR VERIFICATOR/ EXPERT		NUME	SEMNATURA	CERINTA	REFERAT NR.	din
PROIECTANT GENERAL: SC "TDD CONCEPT STUDIO" SRL CIF 23108690, J22/ 223/2008			PROIECTANT SPECIALITATE: SC "ROLPROIECT" SRL CIF 18050370, J22/ 2578/2005		REFERAT / EXPERTIZA NR./ DATA	
SPECIFICATIE			SCARA %		Beneficiar	
SEF PROIECT	NUME		SEMNATURA	CONSILIUL JUDETEAN VASLUI		
PROIECTAT	arh. G.Tanjala Ostapovici			Contract nr. 2025/2010		
DESENAT	ing. Florin BARAN			Faza. PTh		
VERIFICAT	ing. Andreea BARAN			REABILITARE, MODERNIZARE SI ECHIPARE SPITALUL JUDETEAN DE URGENTE VASLUI str. Stefan Cel Mare, nr. 233, Vaslui		
			2016		Scheme de distributie tablouri electrice TC.V, TCV.V, TLIFTURI - instalatii electrice curenti tari -	
					Plansa nr. ET-26/AsB	