


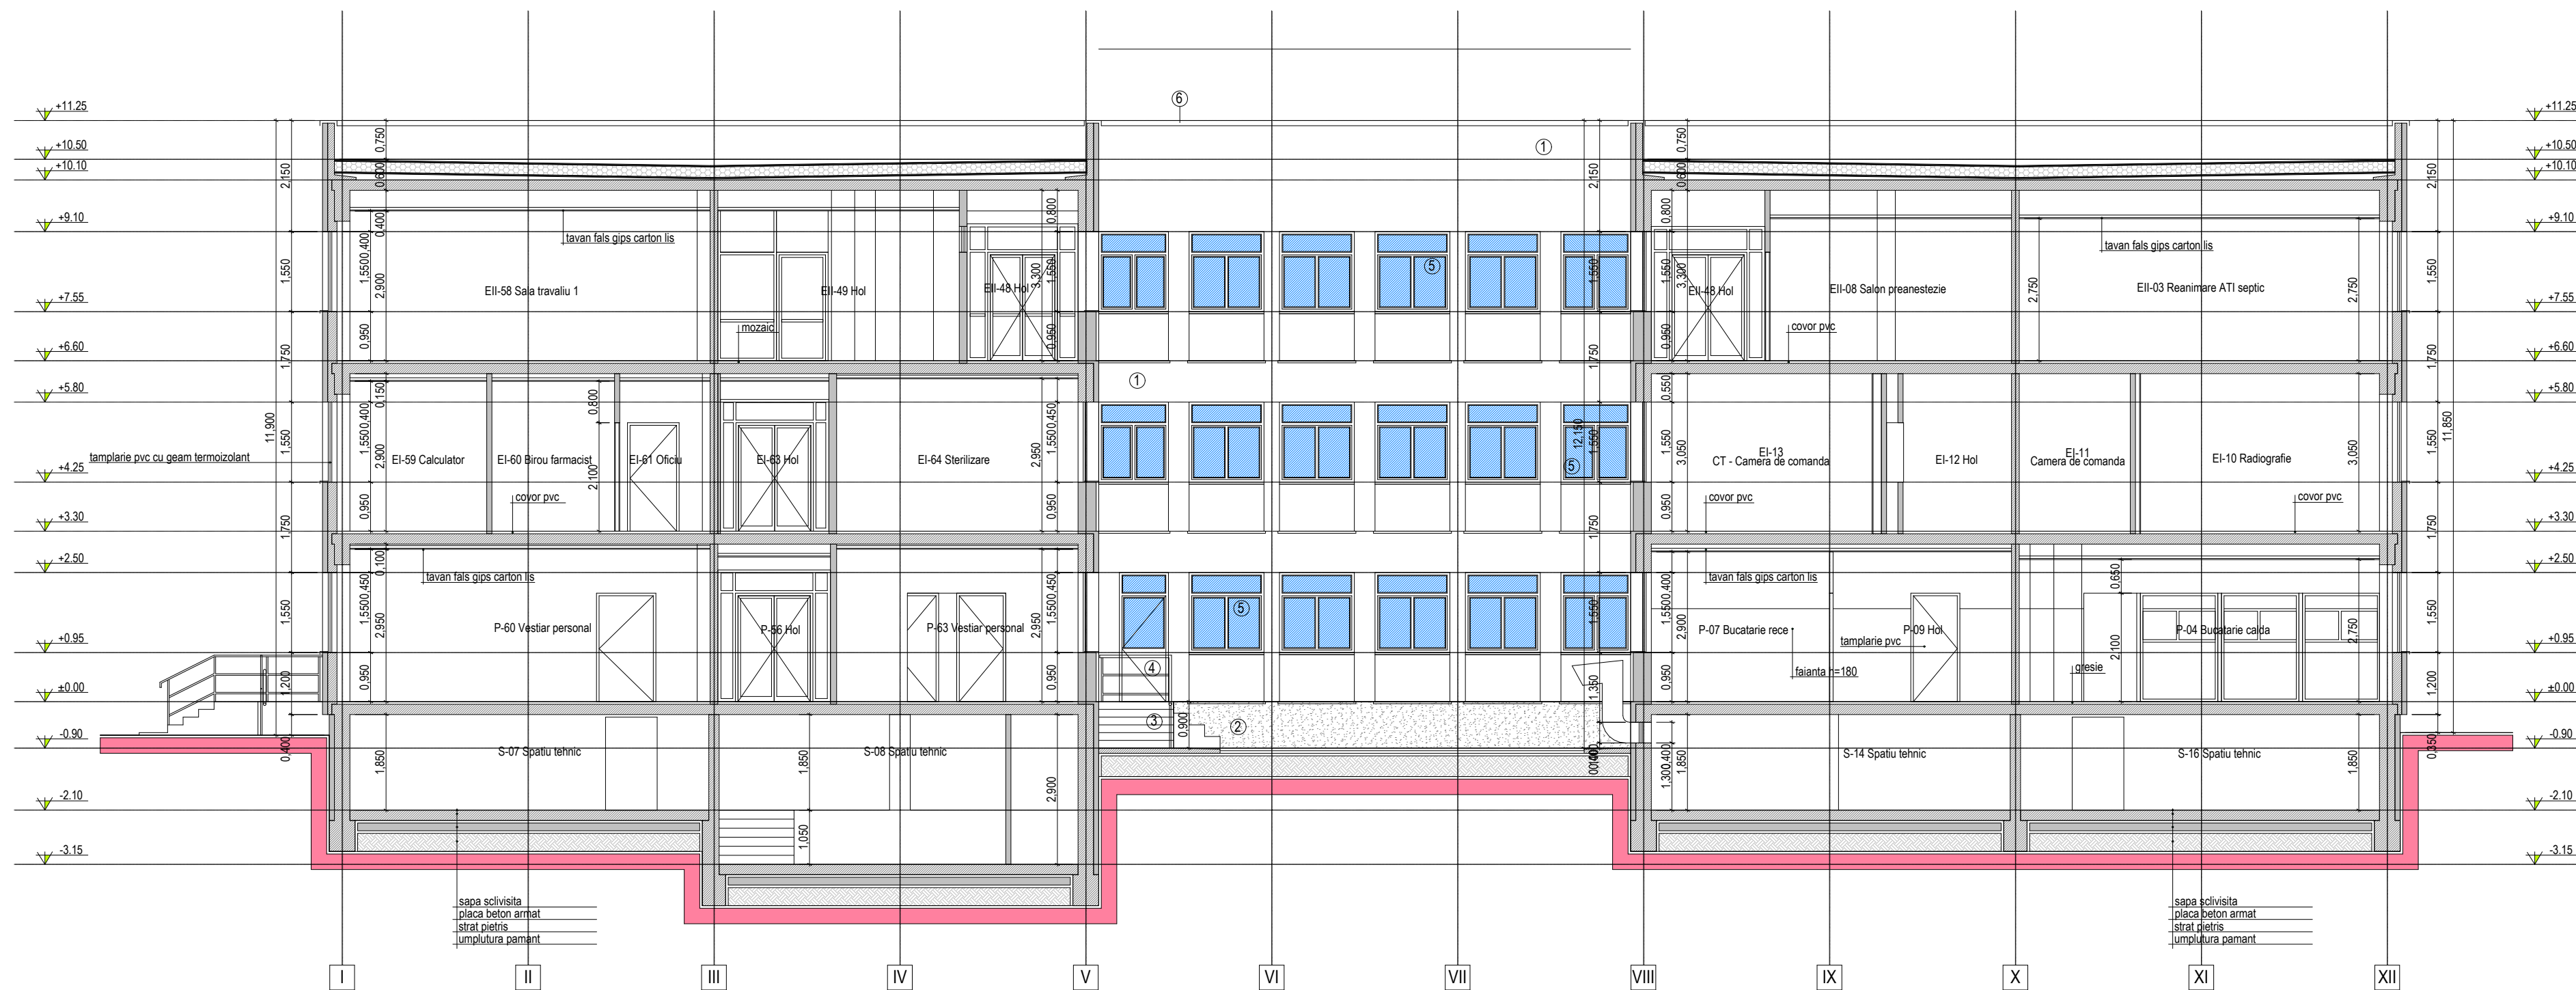

SPITALUL JUDETEAN VASLUI
RELEVU SECTIE A-A
1/100
PL. A4