


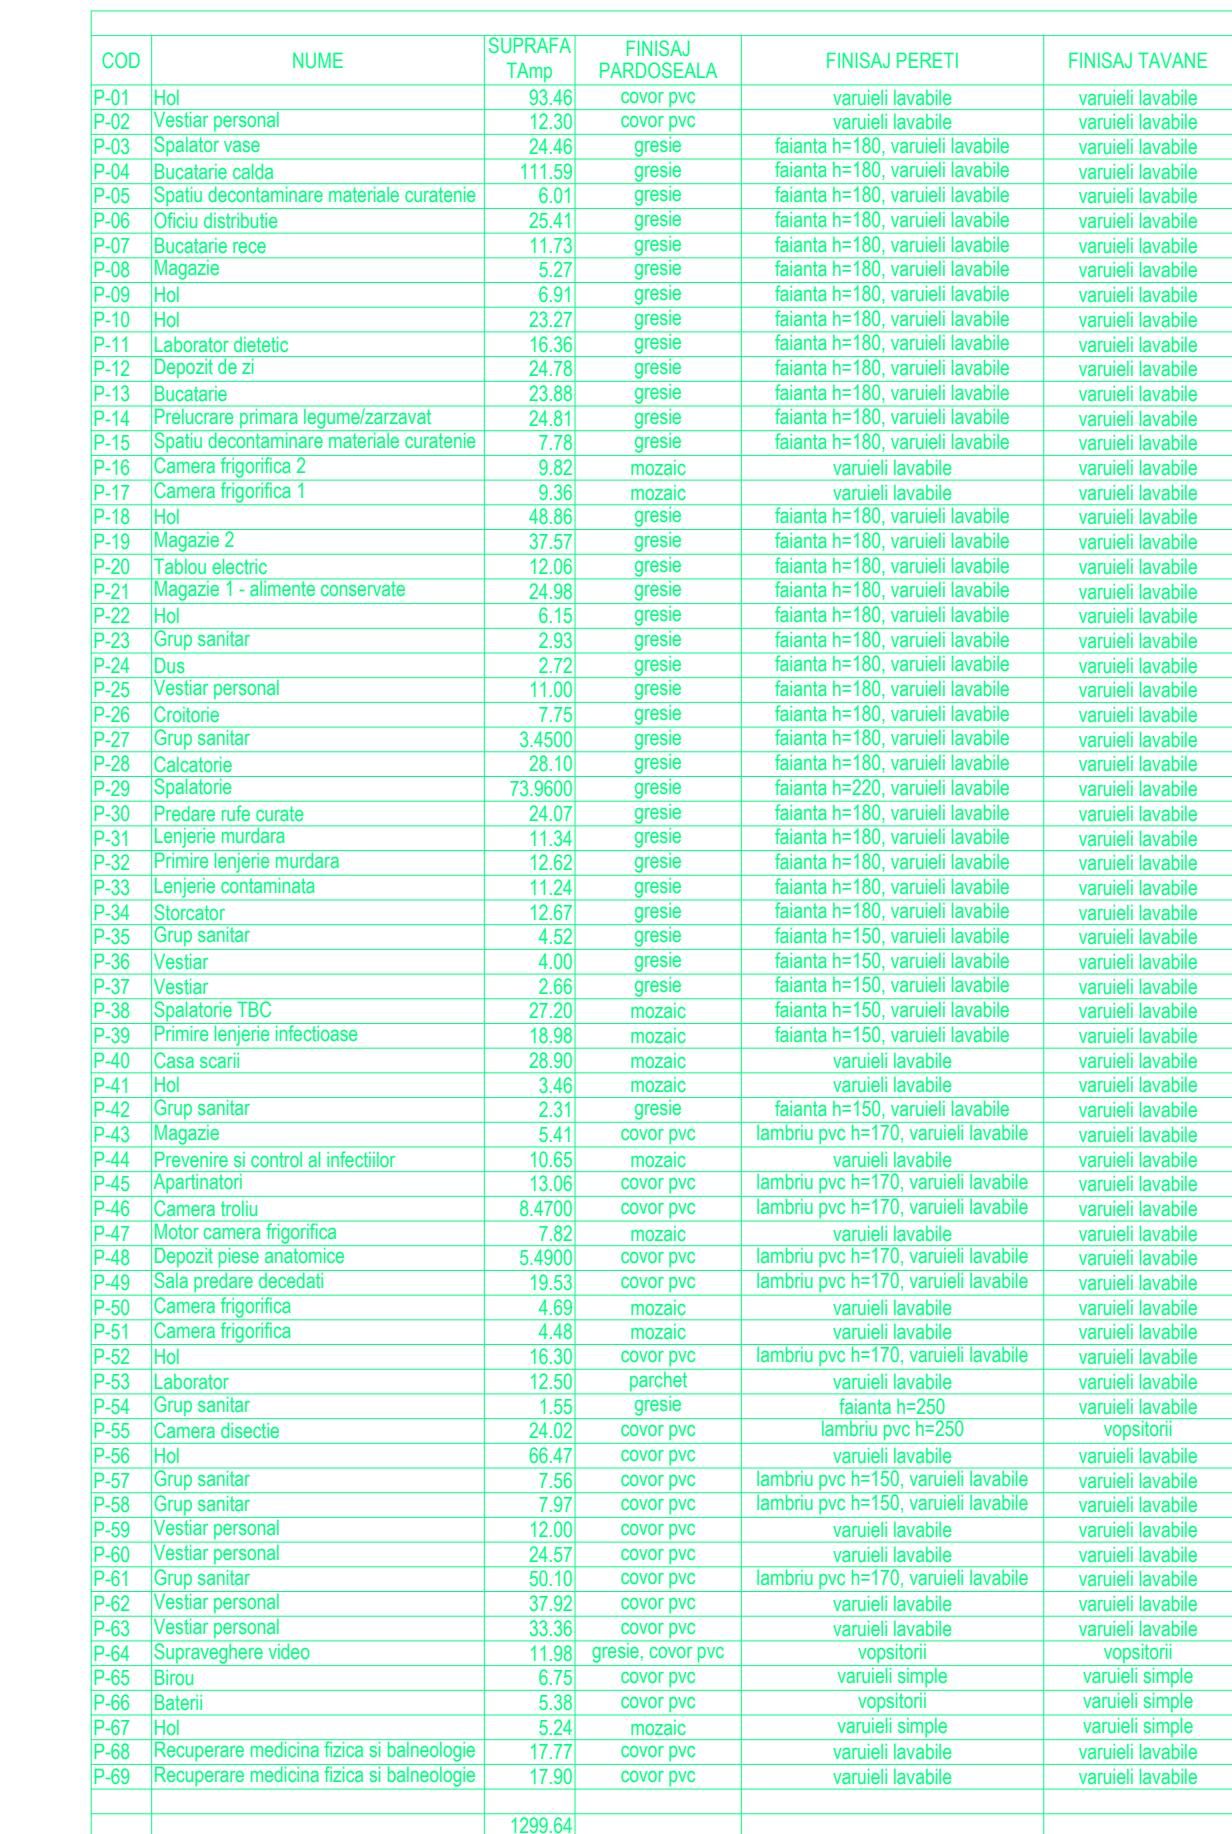

0,20m		PERETE EXTERIOR - 20cm perle structurale din beton armat clasa A1 reactie la foc EI 420mm
0,15m		PERETE INTERIOR - 15cm perle structurale din beton armat clasa A1 reactie la foc EI 420mm
0,10m		PERETE INTERIOR - 10cm, 15cm perle din blocuri ceramice clasa A1 reactie la foc EI 420mm
0,05m		INCHEIERI GHENE - 5cm inchideri din placi gres carton clasa A2 reactie la foc EI 30min
0,10m		INCHEIERI EXTERIOARE - 10cm perle caramida de sileca clasa A1 reactie la foc EI 60min

Suprafata construita = 1614.00 mp
Suprafata deasurata = 4943.30 mp
Suprafata utila totala = 3699.72 mp

Suprafata construita parter = 1614.00 mp
Suprafata utila parter = 1299.64 mp
Suprafata curte interioara = 143.15 mp

POT = existent
CUT = existent

NOTA:
Cladire civila publica - pentru sanatate
Categorie de importanta - B
Clasa de importanta I
Gradul II de rezistenta la foc

PL. A1