


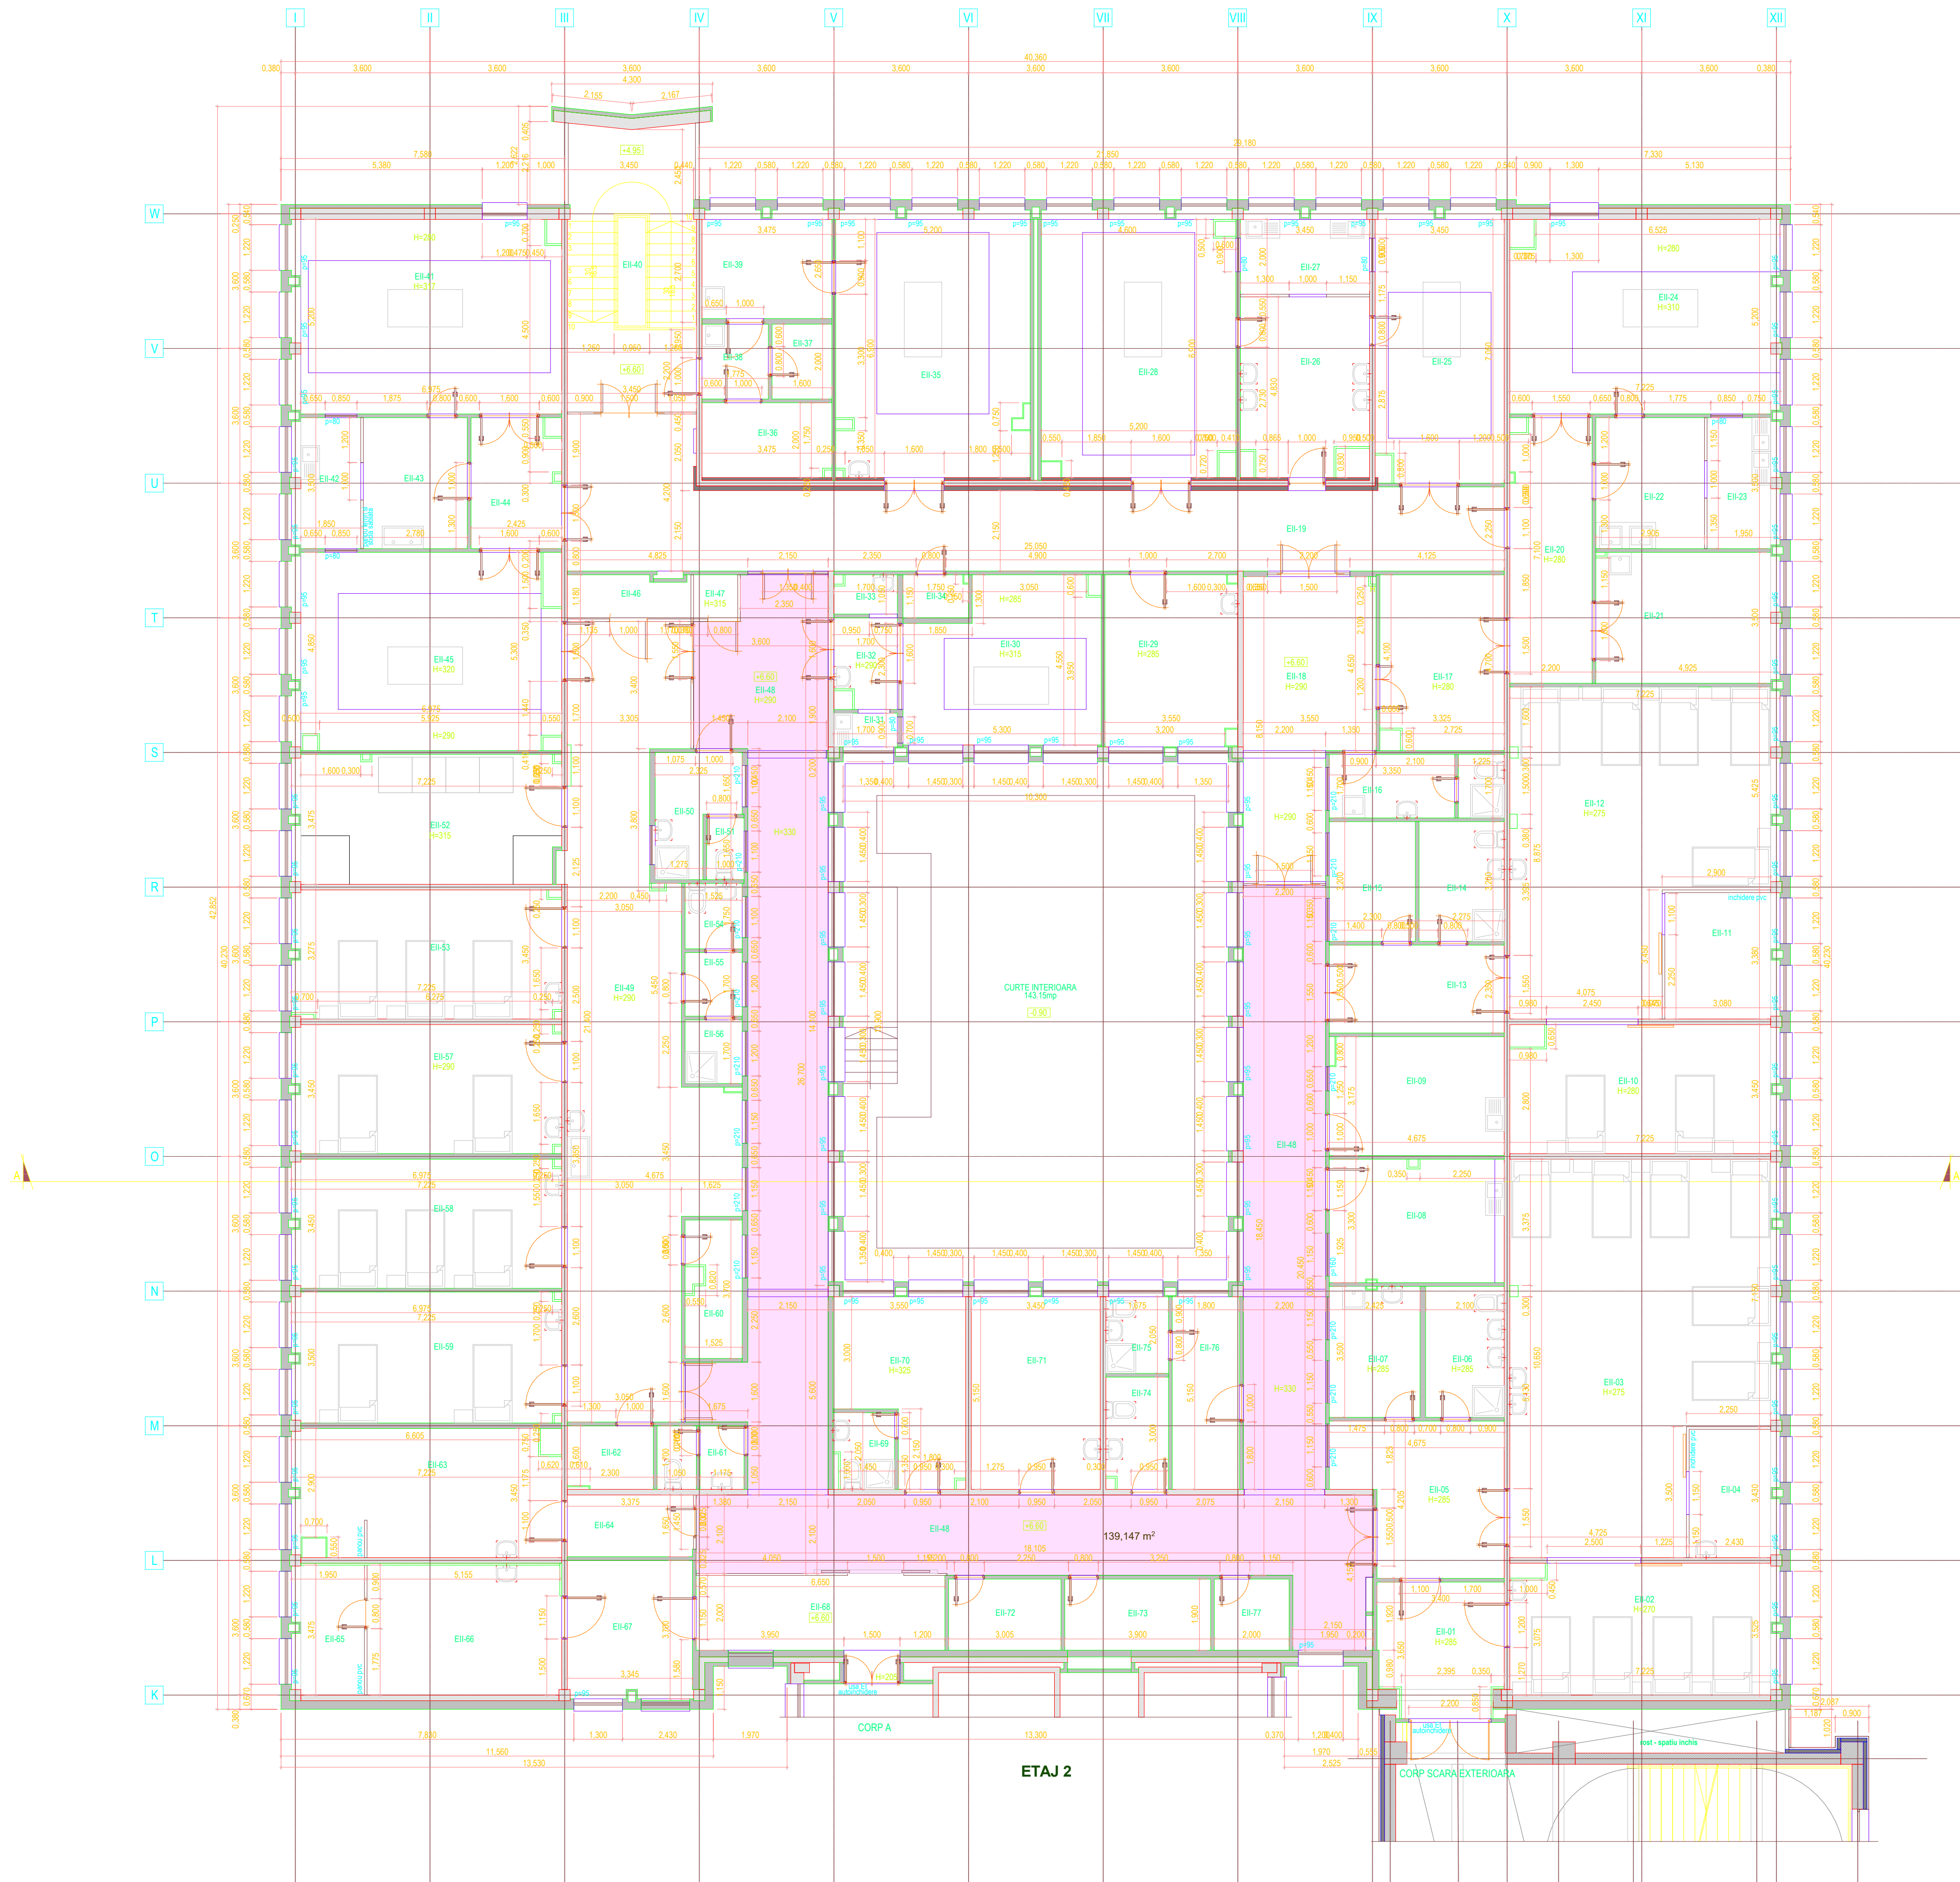

COD	NUME	SUPRAFA Tamp	FINISAJ PARDOSEALA	FINISAJ PERETI	FINISAJ TAVANE
EI-01	Hol	11.50	cover pvc	varuilei lavabile	varuilei lavabile
EI-02	Isolator	24.87	cover pvc	varuilei lavabile	varuilei lavabile
EI-03	Reanimator ATI septic	67.84	cover pvc	varuilei lavabile	varuilei lavabile
EI-04	Post de supraveghere	8.23	cover pvc	varuilei lavabile	varuilei lavabile
EI-05	Hol - Filtru	16.62	mozaic	varuilei lavabile	varuilei lavabile
EI-06	Sotul depozitare	7.35	gresie	faienta h=210, varuilei lavabile	varuilei lavabile
EI-07	Pregalire instrumentar	5.49	mozaic	faienta h=170, varuilei lavabile	varuilei lavabile
EI-08	Salon preanestezie	15.30	cover pvc	vopstoni	varuilei lavabile
EI-09	Oficiu	14.70	mozaic	varuilei lavabile	varuilei lavabile
EI-10	Reanimator ATI aseptice	24.16	cover pvc	varuilei lavabile	varuilei lavabile
EI-11	Post de supraveghere	10.31	cover pvc	varuilei lavabile	varuilei lavabile
EI-12	Terapie intensiva septic	52.88	cover pvc	varuilei lavabile	varuilei lavabile
EI-13	Hol - Filtru	10.99	mozaic	varuilei lavabile	varuilei lavabile
EI-14	Sotul depozitare	7.25	gresie	faienta h=180, varuilei lavabile	varuilei lavabile
EI-15	Magazine bioode	7.36	gresie	faienta h=180, varuilei lavabile	varuilei lavabile
EI-16	Grup sanitar	8.84	gresie	faienta h=150, varuilei lavabile	varuilei lavabile
EI-17	Sala spolare instrumentar	15.26	cover pvc	varuilei lavabile	varuilei lavabile
EI-18	Hol - Filtru	24.26	mozaic	varuilei lavabile	varuilei lavabile
EI-19	Hol	61.91	mozaic	varuilei lavabile	varuilei lavabile
EI-20	Hol distributie	15.35	cover pvc	varuilei lavabile	varuilei lavabile
EI-21	Pregalire materiale	17.06	cover pvc	varuilei lavabile	varuilei lavabile
EI-22	Spolare medic	10.16	cover pvc	varuilei lavabile	varuilei lavabile
EI-23	Spolare instrumenta	6.70	cover pvc	varuilei lavabile	varuilei lavabile
EI-24	Sala operati chirurgie C	36.83	vopsea epoxidica	vopstoni	varuilei lavabile
EI-25	Sala operati chirurgie B	23.92	cover pvc	lambruri pvc	vopstoni
EI-26	Spolare medic	15.68	cover pvc	varuilei lavabile	varuilei lavabile
EI-27	Spolare instrumenta	6.90	cover pvc	varuilei lavabile	varuilei lavabile
EI-28	Sala operati chirurgie A	36.83	lambruri pvc	vopstoni	varuilei lavabile
EI-29	Magazine materiale sanitarie	16.08	mozaic	varuilei lavabile	varuilei lavabile
EI-30	Sala operati	21.47	cover pvc	lambruri pvc	vopstoni
EI-31	Spolare medic	1.55	cover pvc	varuilei lavabile	varuilei lavabile
EI-32	Hol - Filtru	3.85	cover pvc	varuilei lavabile	varuilei lavabile
EI-33	Spolare instrumenta	1.69	cover pvc	varuilei lavabile	varuilei lavabile
EI-34	Magazine materiale sanitarie	9.97	mozaic	varuilei lavabile	varuilei lavabile
EI-35	Sala operati	35.57	vopsea epoxidica	vopstoni	varuilei lavabile
EI-36	Tablou electric	6.85	mozaic	varuilei lavabile	varuilei lavabile
EI-37	Magazine	3.20	mozaic	varuilei lavabile	varuilei lavabile
EI-38	Hol	3.55	mozaic	varuilei lavabile	varuilei lavabile
EI-39	Spolator	9.21	cover pvc	varuilei lavabile	varuilei lavabile
EI-40	Casa scarii	26.18	mozaic	varuilei lavabile	varuilei lavabile
EI-41	Sala operati obstetrica-ginecologie	35.95	vopsea epoxidica	vopstoni	vopstoni
EI-42	Spolare instrumenta	6.35	vopsea epoxidica	varuilei lavabile	varuilei lavabile
EI-43	Spolare medic	9.73	vopsea epoxidica	varuilei lavabile	varuilei lavabile
EI-44	Hol	8.14	vopsea epoxidica	varuilei lavabile	varuilei lavabile
EI-45	Sala operati obstetrica-ginecologie	35.69	vopsea epoxidica	vopstoni	vopstoni
EI-46	Magazine materiale sanitarie	3.70	mozaic	varuilei lavabile	varuilei lavabile
EI-47	Magazine bioode	1.30	mozaic	varuilei lavabile	varuilei lavabile
EI-48	Hol	139.09	mozaic	varuilei lavabile	varuilei lavabile
EI-49	Hol	68.70	mozaic	varuilei lavabile	varuilei lavabile
EI-50	Filtru medic	6.07	gresie	varuilei lavabile	varuilei lavabile
EI-51	Grup sanitar	1.65	gresie	faienta h=150, varuilei lavabile	varuilei lavabile
EI-52	Sala pregatire materiale	24.66	gresie	varuilei lavabile	varuilei lavabile
EI-53	Sala travaliu 2	24.60	cover pvc	varuilei lavabile	varuilei lavabile
EI-54	Grup sanitar	2.67	gresie	faienta h=150, varuilei lavabile	varuilei lavabile
EI-55	Hol	2.59	gresie	varuilei lavabile	varuilei lavabile
EI-56	Grup sanitar	2.59	gresie	faienta h=200, varuilei lavabile	varuilei lavabile
EI-57	Sala expulzie 2	24.73	cover pvc	varuilei lavabile	varuilei lavabile
EI-58	Sala travaliu 1	24.80	cover pvc	varuilei lavabile	varuilei lavabile
EI-59	Sala expulzie 1	25.04	cover pvc	vopstoni	vopstoni
EI-60	Magazine	5.27	gresie	varuilei lavabile	varuilei lavabile
EI-61	Grup sanitar	3.85	gresie	faienta h=150, varuilei lavabile	varuilei lavabile
EI-62	Registratura	3.85	gresie	varuilei lavabile	varuilei lavabile
EI-63	Punct de transfuzii	23.96	gresie	varuilei lavabile	varuilei lavabile
EI-64	Hol	5.52	gresie	varuilei lavabile	varuilei lavabile
EI-65	Camera sterilizare	6.65	cover pvc	varuilei lavabile	varuilei lavabile
EI-66	Camera interventii endoscopice	18.03	cover pvc	varuilei lavabile	varuilei lavabile
EI-67	Astuterie	12.33	mozaic	varuilei lavabile	varuilei lavabile
EI-68	Hol	13.30	mozaic	varuilei lavabile	varuilei lavabile
EI-69	Grup sanitar	3.18	gresie	faienta h=200, varuilei lavabile	varuilei lavabile
EI-70	Camera garda sedie	14.43	parchet	varuilei lavabile	varuilei lavabile
EI-71	Camera garda	17.76	parchet	varuilei lavabile	varuilei lavabile
EI-72	Opotit terapezie	5.71	mozaic	varuilei lavabile	varuilei lavabile
EI-73	Magazine materiale sanitarie	7.41	mozaic	varuilei lavabile	varuilei lavabile
EI-74	Grup sanitar personal	4.92	gresie	faienta h=150, varuilei lavabile	varuilei lavabile
EI-75	Grup sanitar	3.43	gresie	faienta h=150, varuilei lavabile	varuilei lavabile
EI-76	Seruri	9.27	gresie	varuilei lavabile	varuilei lavabile
EI-77	Asistent sef	3.80	mozaic	varuilei lavabile	varuilei lavabile
		1308.98			

SPATIUL CARE TREBUIE VENTILAT

0.200	PERETE EXTERIOR - 28cm perete structural din beton armat clasa A1 reactie la foc REI 420mm
0.150	PERETE INTERIOR - 15cm perete structural din beton armat clasa A1 reactie la foc REI 420mm
0.100	PERETE INTERIOR - 10cm, 15cm perete structural din beton armat clasa A2 reactie la foc EI 420mm
0.050	INCHEIERI GHENE - 5cm inchideri din plac gips carton clasa A2 reactie la foc EI 30mm
0.100	INCHEIERI EXTERIOARE - 10cm perete caramida de sticlă clasa A1 reactie la foc EI 50mm

Suprafata constructia = 1614.00 mp
Suprafata desfasurata = 4843.30 mp
Suprafata utila totala = 3899.72 mp

Suprafata constructia etaj II = 1614.65 mp
Suprafata utila etaj II = 1305.98 mp
Suprafata curte interioara = 143.15 mp

POT = existent
CUT = existent

NOTA:
Cladire civila publica - pentru sanitate
Categorie de importanta = B
Clasa de importanta I
Gradul II de rezistenta la foc
Risc mic de incendiu

SPITALUL JUDETEAN VASLUI
RELEVU ETAJ 2 CU MARCAREA
SPATIILOR CARE TREBUIESC VENTILATE