



Cod: 737033, Romania, Loc Salcioara, Jud. Vaslui,
Tel: 0235411515, Fax: 0235426333
Email: office@transmir.ro
Web: www.transmir.ro



Constructii de drumuri si poduri, asfaltari, foraje si aductiuni de apa

Nr. 1601 / 09.09.2019



Dir. Tehnic
[Signature]

CATRE: JUDETUL VASLUI
Str. Stefan cel Mare nr 79, Localitatea: Vaslui

Fax: 0235-361 091

Va inaintam fisa de executie a forajelor si buletinul de analiza pentru statia de monitorizare a apelor subterane de la obiectivul „INCHIDERE DEPOZIT EXISTENT BARLAD”

Cu stima,


VIP
[Signature]

S.C. TRANSMIR S.R.L.



FORAJ NR. GWM1


FISA DE EXECUTIE FORAJ PENTRU STATIA DE
MONITORIZARE A APELOR SUBTERANE -
INCHIDERE DEPOZIT BARLAD

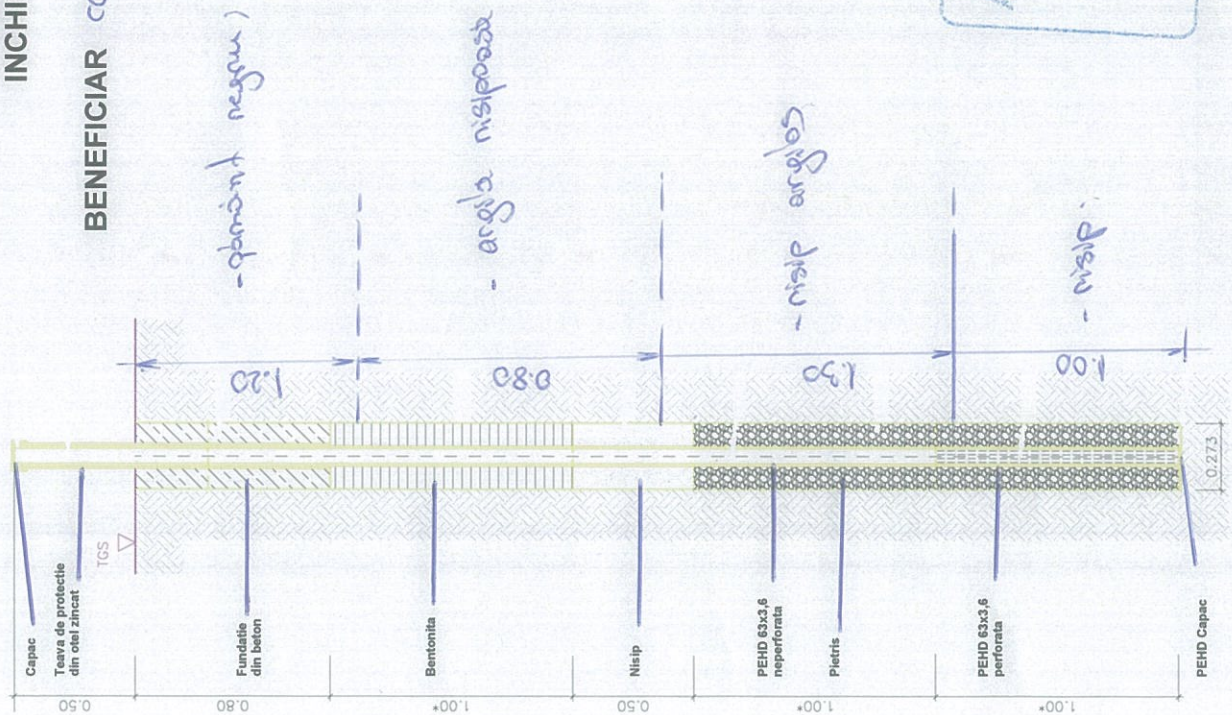

EXECUTANT

BENEFICIAR *consiliul judetean Vaslui*

S. REBASTIAN SRL

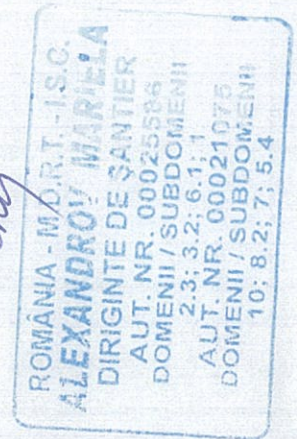

S.C. PRO MEDIU ECO SRL IASI
 Sos. Nationala nr. 194, bl. D, sc. D, ap. 28
 TEL/FAX.: 0232-213643
 MOBIL.: 0722-400703

LABORATOR FACTORI DE MEDIU
 B-dul Mangeron nr. 63
 (in incinta facultatii de chimie ind.)

BULETIN DE ANALIZA nr. 106 / 20.08.2019

cuprinzand rezultatele analizelor apei subterane prelevata din statiile de monitorizare de la DEPOZITUL DE DESEURI
 BARLAD, judetul Vaslui, 19.08.2019.

Nr. crt.	INDICATORI	Apa subterana	Apa industriala	Metoda de analiza	Norme admise apelor nr. 458/08.07.2001	Legea
1	pH	9.49	-	SR ISO 10523-97	6,5 - 9,5	
2	Rezidu total mg/l	429	-	STAS 6953-81		
3	Rezidu fix mg/l	425	-	STAS 6953-81	2000 NTPA 001	
4	Suspensii mg/l	4	-	STAS 6953-81	35 NTPA 001	
5	CCOCr mgO ₂ /l	80	-	SR ISO 6060-96	70 NTPA 001	
6	Amoniu mg/l	0.022	-	STAS 8683-70	0.50	
7	Azotiti mg NO ₂ /l	0.144	-	STAS 8900/2-71	0.50	
8	Azotati mg NO ₃ /l	6.46	-	STAS 8900/1-71	50	
9	Fosfor total mg/l	0.965	-	SR EN 1189-99	1.0 NTPA 001	
10	Azot total mg N/l	0.48	-	STAS 7312-83	10 NTPA 001	
11	Cloruri mg/l	24.83	-	STAS 8663-70	350	
12	Sulfuri si hidrogen sulfurat mg S ²⁻ /l	abs	-	SR ISO 10530-97	0.100	
13	Sulfati mg/l	27.9	-	STAS 8601-70	250	
14	Fenoli mg/l	0.09	-	STAS R 7167-92	0.3 NTPA 001	
15	Substante extractibile mg/l	1.5	-	SR 7587-96	20 NTPA 001	
16	Cianuri totale mg/l	abs	-	SR ISO 6703/1-98	0.05	
17	Mangan mg Mn/l	0.268	-	STAS 8662/1-96	0.050	
18	Crom total mg Cr/l	abs	-	STAS 7884-91	0.05	
19	Zinc mg Zn/l	0.90	-	STAS 8314-87	5.0	
20	Nichel mg Ni/l	abs	-	STAS 7987-80	0.02	
21	Cupru mg Cu/l	0.017	-	STAS 7795-80	0.1	
22	Plumb mg Pb/l	abs	-	STAS 8637-79	0.01	
23	Fier mg Fe/l	0.035	-	SR ISO 6332-96	0.200	

NOTA-concentraziile indicatorilor determinati s-au situat sub limitele admise, CCOCr depasind cu 14% limita NTPA 001.

Executat analize

S.C. PRO MEDIU ECO SRL IASI

DIRECTOR


ING. ICHIM IERONIM

Ing. Ichim Ieronim, Sing Bantas Mihai



FISA DE EXECUTIE FORAJ PENTRU STATIA DE
MONITORIZARE A APELOR SUBTERANE -
INCHIDERE DEPOZIT BARLAD

FORAJ NR. GWM2

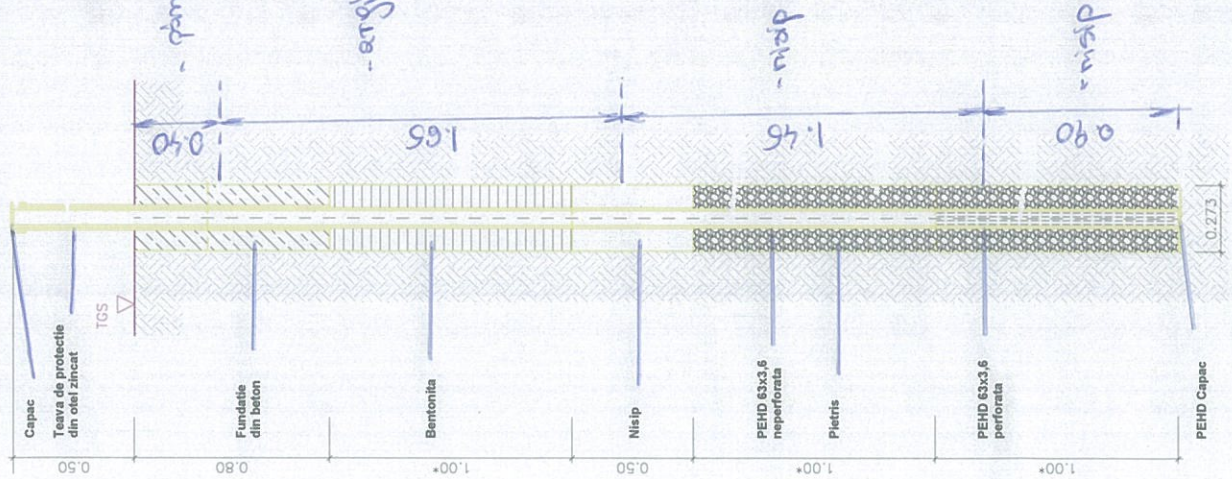

EXECUTANT

SC TRANSMIR SEC



ROMANIA - M.D.R.T. - I.S.O.
ALEXANDROV MARIA
DIRIGINTE DE ȘANTIER
AUT. NR. 00025585
DOMENII / SUBDOMENII
2.3; 3.2; 6.1; 1
AUT. NR. 00021075
DOMENII / SUBDOMENII
10; 8.2; 7; 5.4

SC "PRO MEDIU ECO" SRL IASI
Sos. Nationala nr. 194, bl.D, sc.D, ap.28
TEL/FAX.: 0232-213643
MOBI.: 0722-400703

LABORATOR FACTORI DE MEDIU
B-dul Mangeron nr 63
(in incinta facultatii de chimie ind.)

BULETIN DE ANALIZA nr. 106 / 20.08.2019

cuprinzand rezultatele analizelor apei subterane prelevata din statiile de monitorizare de la DEPOZITUL DE DESEURI
BARLAD, judetul Vaslui, 19.08.2019.

Nr. crt.	INDICATOR	Apa subterana	Apa industriala	Metoda de analiza	Norme admise apelor nr.458/08.07.2002	Legea
1	pH	9.49	-	SR ISO 10523-97	6.5 - 9.5	
2	Rezidu total mg/l	429	-	STAS 6953-81		
3	Rezidu fix mg/l	425	-	STAS 6953-81	2000 NTPA 001	
4	Suspensii mg/l	4	-	STAS 6953-81	35 NTPA 001	
5	CCOCr mgO ₂ /l	80	-	SR ISO 6060-96	70 NTPA 001	
6	Amoniu mg/l	0.022	-	STAS 8683-70	0.50	
7	Azotiti mg NO ₂ /l	0.144	-	STAS 8900/2-71	0.50	
8	Azotati mg NO ₃ /l	6.46	-	STAS 8900/1-71	50	
9	Fosfor total mg/l	0.965	-	SR EN 1189-99	1.0 NTPA 001	
10	Azot total mg N/l	0.48	-	STAS 7312-83	10 NTPA 001	
11	Cloruri mg/l	24.83	-	STAS 8663-70	250	
12	Sulfuri si hidrogen sulfurat mg S ²⁻ /l	abs	-	SR ISO 10530-97	0.100	
13	Sulfati mg/l	27.9	-	STAS 8601-70	250	
14	Fenoli mg/l	0.09	-	STAS R 7167-92	0.3 NTPA 001	
15	Substante extractibile mg/l	1.5	-	SR 7587-96	20 NTPA 001	
16	Cianuri totale mg/l	abs	-	SR ISO 6703/1-98	0.05	
17	Mangan mg Mn/l	0.268	-	STAS 8662/1-96	0.050	
18	Crom total mg Cr/l	abs	-	STAS 7884-91	0.05	
19	Zinc mg Zn/l	0.90	-	STAS 8314-87	5.0	
20	Nichel mg Ni/l	abs	-	STAS 7987-80	0.02	
21	Cupru mg Cu/l	0.017	-	STAS 7795-80	0.1	
22	Plumb mg Pb/l	abs	-	STAS 8637-79	0.01	
23	Fier mg Fe/l	0.055	-	SR ISO 6332-96	0.200	

NOTA- concentratiile indicatorilor determinati s-au situat sub limitele admise, CCOCr depasind cu 14% limita NTPA 001.

SC "PRO MEDIU ECO" SRL IASI

DIRECTOR


Executat analize

Ing. Iulian Ieronim, Sing. Bantas Mihai



FISA DE EXECUTIE FORAJ PENTRU STATIA DE
MONITORIZARE A APELOR SUBTERANE -
INCHIDERE DEPOZIT BARLAD

FORAJ NR. GWM3

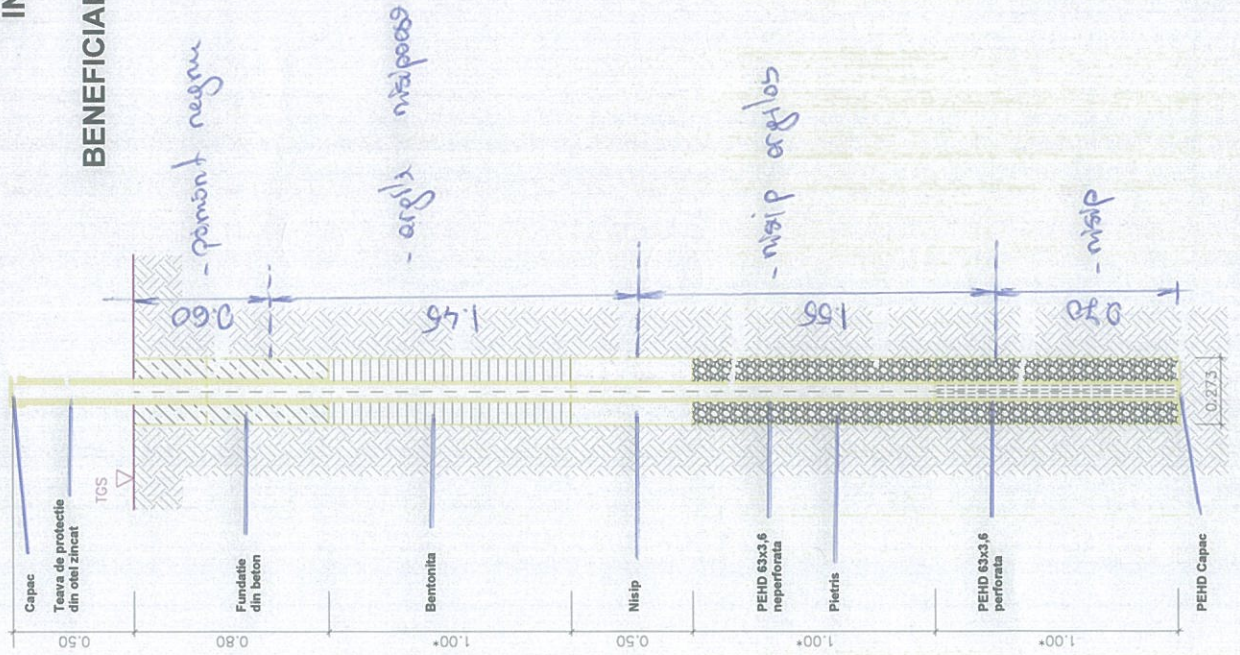

EXECUTANT

SC TRANSMIR SRL



ROMANIA - M.D.R.T. - I.S.C.
ALEXANDROV MARIU
DIRIGINTE DE SANTIER
AUT. NR. 00025586
DOMENII / SUBDOMENII
2.3; 3.2; 6.1; 1
AUT. NR. 00021075
DOMENII / SUBDOMENII
10; 8.2; 7; 5.4

SCTPRO MEDIU ECO SRL IASI
Sos. Nationala nr. 194, bl.D, sc.D, ap.28
TEL/FAX.: 0232-213643
MOBIL.: 0722-400703

LABORATOR FACTORI DE MEDIU
B-dul Mangeron nr 63
(in incinta facultatii de chimie ind.)

BULETIN DE ANALIZA nr. 106 / 20.08.2019

cuprinzand rezultatele analizelor apei subterane prelevata din statiile de monitorizare de la DEPOZITUL DE DESEURI
BARLAD, judetul Vaslui, 19.08.2019.

Nr. crt.	INDICATORI	Apa subterana	Apa industriala	Metoda de analiza	Norme admise apelor nr.458/08.07.2002	Legua
1	pH	9.49	-	SR ISO 10523-97	6.5 - 9.5	
2	Reziduu total mg/l	429	-	STAS 6953-81	-	
3	Reziduu fix mg/l	435	-	STAS 6953-81	2000 NTPA 001	
4	Suspensii mg/l	4	-	STAS 6953-81	35 NTPA 001	
5	CCOCr mgO ₂ /l	80	-	SR ISO 6060-96	70 NTPA 001	
6	Amoniu mg/l	0.022	-	STAS 8683-70	0.50	
7	Azotiti mg NO ₂ /l	0.144	-	STAS 8900/2-71	0.50	
8	Azotati mg NO ₃ /l	6.46	-	STAS 8900/1-71	50	
9	Fosfor total mg/l	0.965	-	SR EN 1189-99	1.0 NTPA 001	
10	Azot total mg N/l	0.48	-	STAS 7312-83	10 NTPA 001	
11	Cloruri mg/l	24.83	-	STAS 8663-70	250	
12	Sulfuri si hydrogen sulfurat mg S ⁻² /l	abs	-	SR ISO 10530-97	0.100	
13	Sulfati mg/l	27.9	-	STAS 8601-70	250	
14	Fenoli mg/l	0.09	-	STAS R 7167-92	0.3 NTPA 001	
15	Substante extractibile mg/l	1.5	-	SR 7587-96	20 NTPA 001	
16	Cianuri totale mg/l	abs	-	SR ISO 6703/1-98	0.05	
17	Mangan mg Mn/l	0.268	-	STAS 8662/1-96	0.050	
18	Crom total mg Cr/l	abs	-	STAS 7884-91	0.05	
19	Zinc mg Zn/l	0.90	-	STAS 8314-87	5.0	
20	Nichel mg Ni/l	abs	-	STAS 7987-80	0.02	
21	Cupru mg Cu/l	0.017	-	STAS 7795-80	0.1	
22	Plumb mg Pb/l	abs	-	STAS 8637-79	0.01	
23	Fier mg Fe/l	0.055	-	SR ISO 6332-96	0.200	

NOTA- concentratiile indicatorilor determinati s-au situat sub limitele admise, CCOCr depasind cu 14% limita NTPA 001.

SCTPRO MEDIU ECO SRL IASI

DIRECTOR ING. ICHIM IERONIM

Executat analize

Ing. Ichim Ieronim, Sing. Bantas Mihai

